


REVISION HISTORY				
ZONE	REV	DESCRIPTION	DATE	APPROVED
C4	A	1. REVISED DWG TO REFLECT AS BUILT CONDITION.	06/16/10	FURCHES SMITH

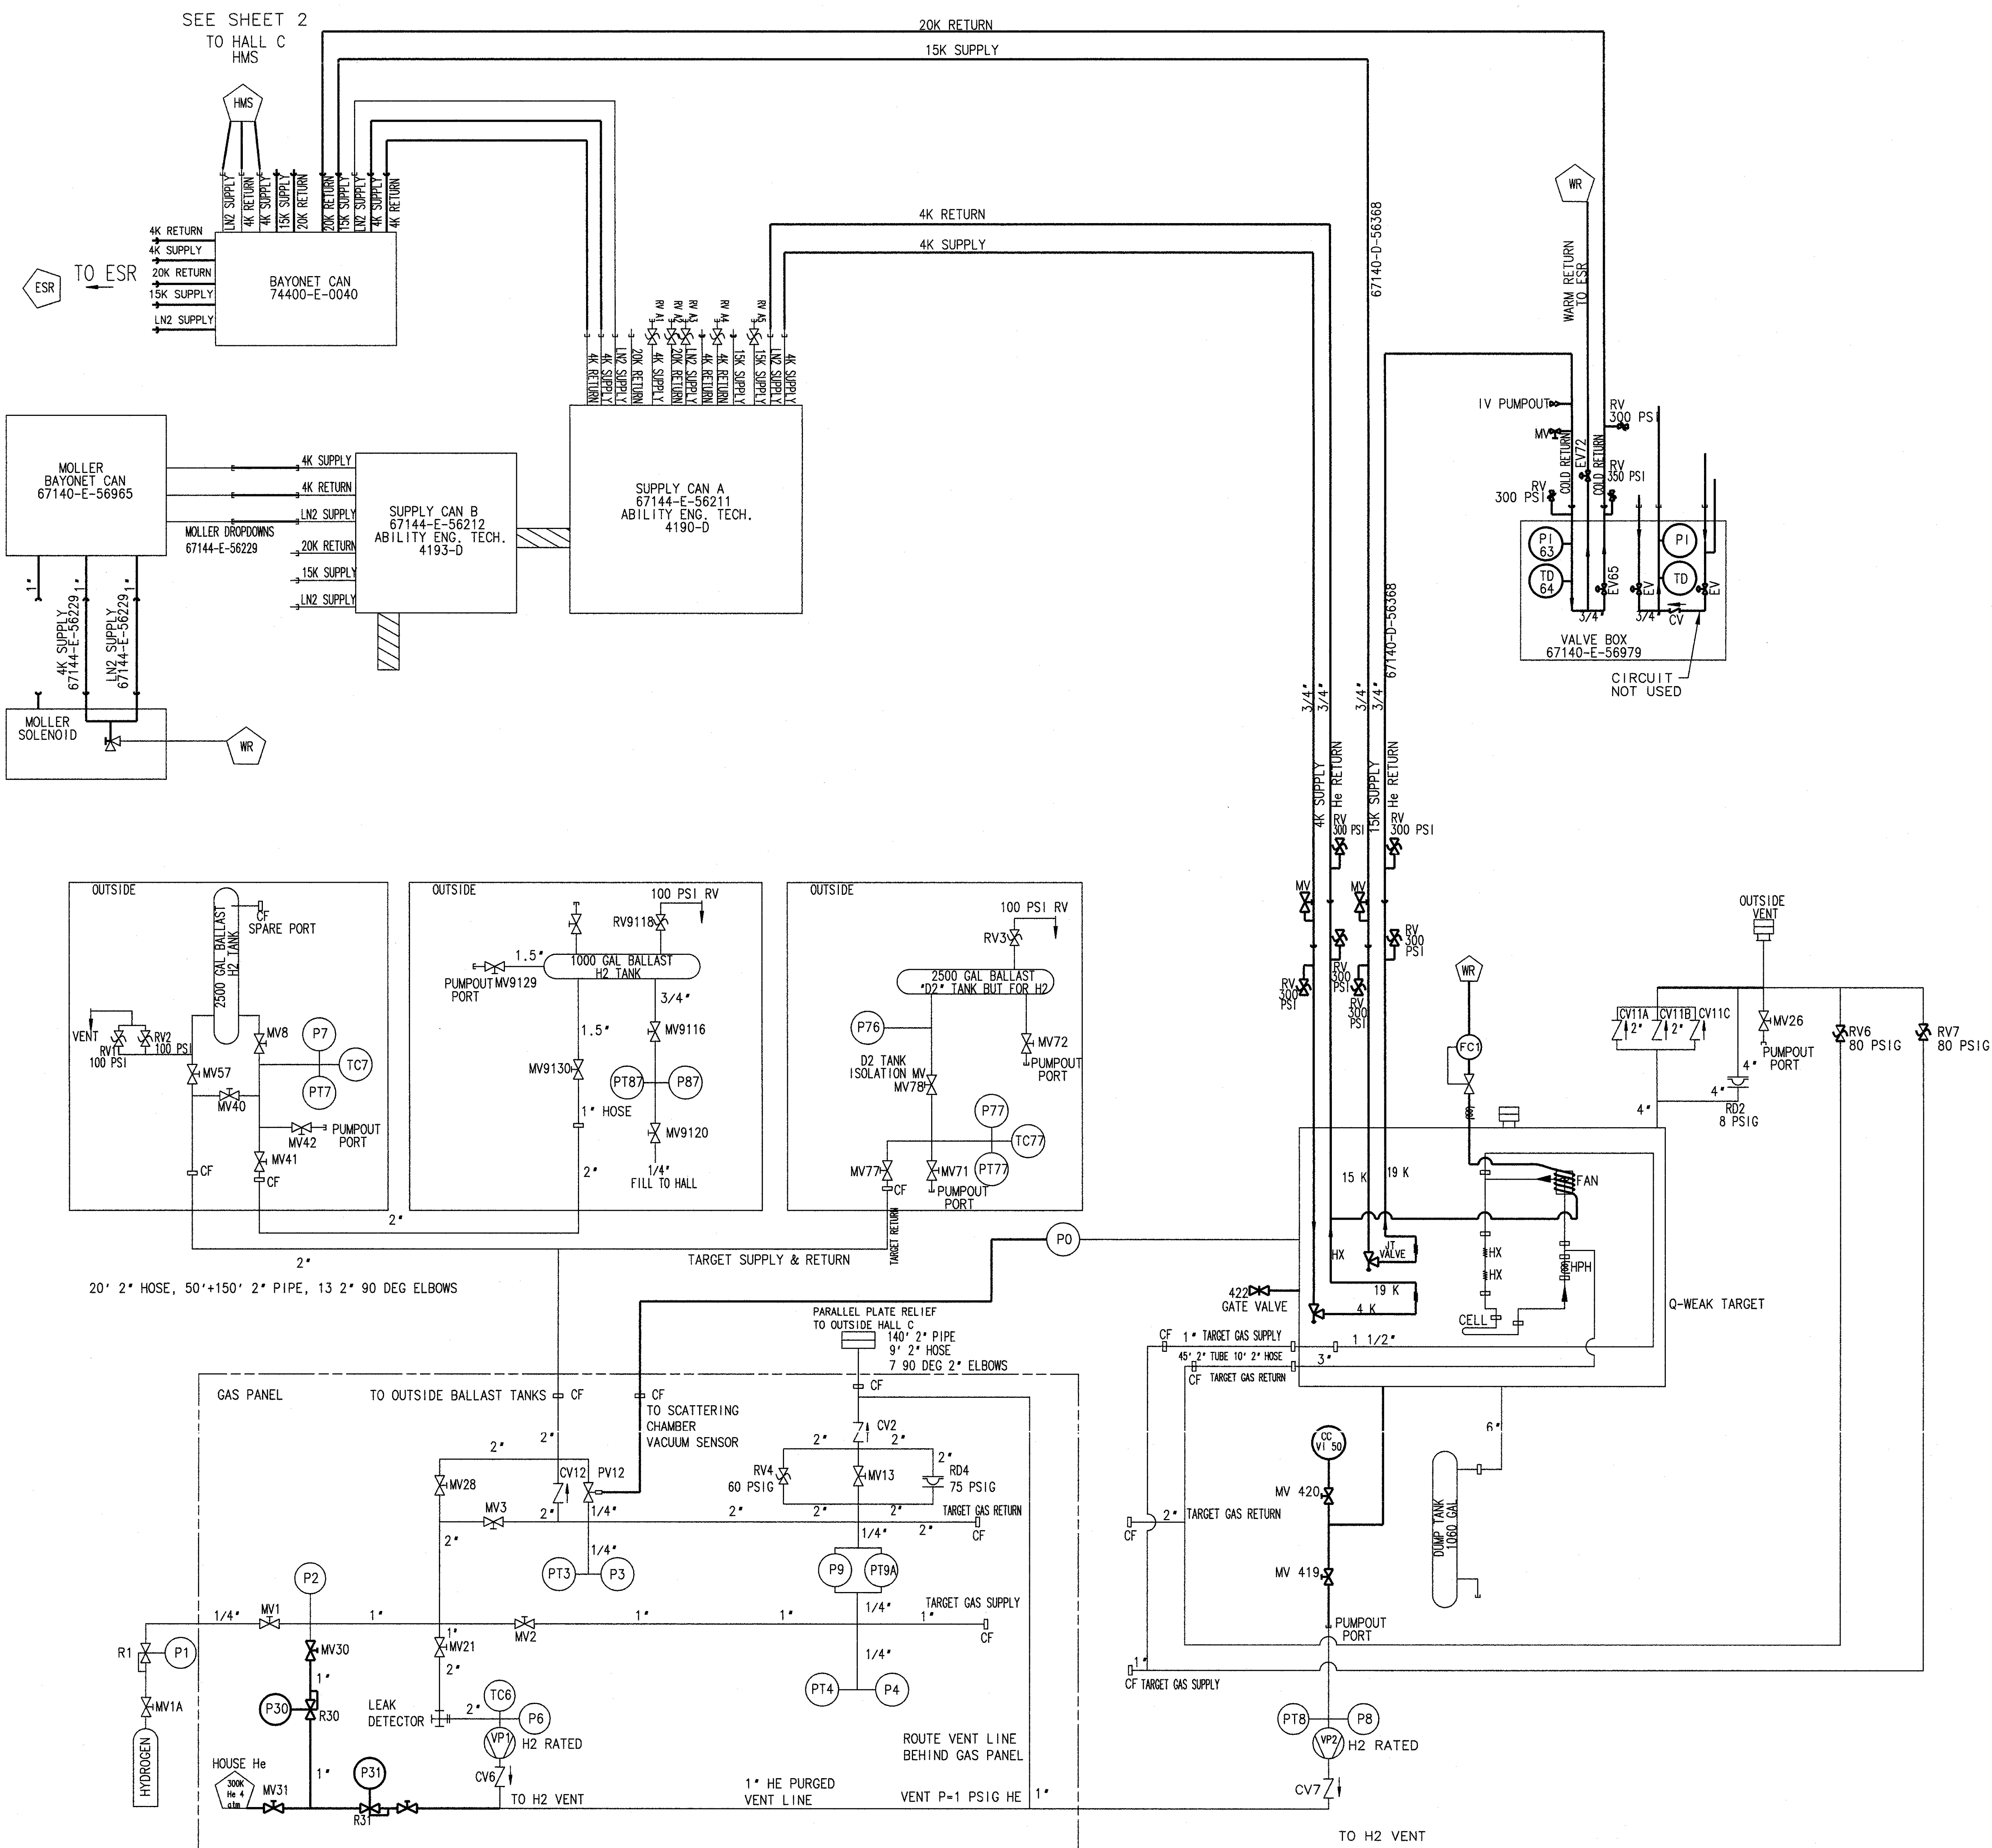

EACH SHEET OF MULTI-SHEET DRAWINGS SHALL ALWAYS HAVE THE SAME REVISION LEVEL.				
APPROVALS	DATE	DOCUMENT CONTROL STAMP	TRACKING NO.	UNITED STATES DEPARTMENT OF ENERGY
SMITH	03/04/10	DCG	N/A	Jefferson Lab Thomas Jefferson National Accelerator Facility
MATERIAL		THIRD ANGLE PROJECTION	APPROVALS	DATE
FINISH 125 UNLESS OTHERWISE NOTED			FURCHES	05/15/09
DO NOT SCALE DRAWING			CHECKED	03/02/10
			APPROVED	03/04/10
			APPROVED	03/04/10
			SCALE	NONE
			USED ON	SHEET 1 OF 2