

JSA/JEFFERSON LAB
CONSTRUCTION CHANGE REQUEST (CCR)

1 Subcontract No: 10-C0162

Date: 7/6/2011

2 Project Title: Technology and Engineering Development Facility Project

3 CCR No: 16

PR No.

4 CCR Title: Bent Plate at Knock Out Panels (4xTLA)

5 Description:

Add continuous 3/8" steel plate and weld to T.O. to steel beam/tube at the knock out panels at the Test Lab addition. (4 locations) See response to RFI 450

6 Changes in Drawings/Sketches:

CPA-0029

7 Changes in Specifications:



REQUEST FOR INFORMATION No. 00450

Date: 7/5/2011	Project: TEDF, Jefferson Lab 12500 Lawrence Road Newport News, VA 23606
To: EwingCole Architects Federal Reserve Bank Building 100 North 6th Street Philadelphia, PA 19106-1590	Phone: 763-287-5652 Fax: 763-287-5462
Fax: 215-574-0952 # of pages faxed: _____	Project No: 09110016
Attn: Shawkat Shamaa	Issue No.: 07-031
Ref:	Required Response Date: 7/12/2011
Title: TLA - Knockout Wall Panel Head Dtl	

Description

Spec. Section(s): 07 42 13, 04 20 00, 05 12 00
Drawing No.(s): S2.1.4.C, S2.1.7.C, TLR-A3.1.1.3, TLR-A3.1.1.4, Centria Shop D5
Location(s): TLA Knockout Wall

Request and/or Proposed Solution: The South knockout wall for the 450 ton press is to be at 21', the metal panel shop drawings show the panels to have a joint and fastened to CMU backup (1/D5). Please see attached picture for the approx. location of this joint for the knockout panel. When the CMU back up is removed to create the knockout opening, there will only be a sliver of CMU block that the metal panel subgirt can attached to, this CMU is also unsupported, and some sort of structural lintel/tube steel would be required. If the CMU back up is to be completed removed, the metal panel will need back up to attached the subgirt.

There is a very similar situation on the West side of TLA, but the knockout walls are at 20'.
Please review and advise.


Requested By: Tony Shieh **Date:** 7/5/2011
Tony Shieh
Project Engineer
antonio.shieh@mortenson.com

Response:

Please provide continuous 3/8" steel plate and weld to T.O. steel beam / tube above knock out panels. Knock out panel head joint to be 3" above T.O. steel at Equip. Platform level. See section detail on attached CPA-0029.

Response By: Shawkat Shamaa **Date:** 07/05/11
Shawkat Shamaa


CC: _____

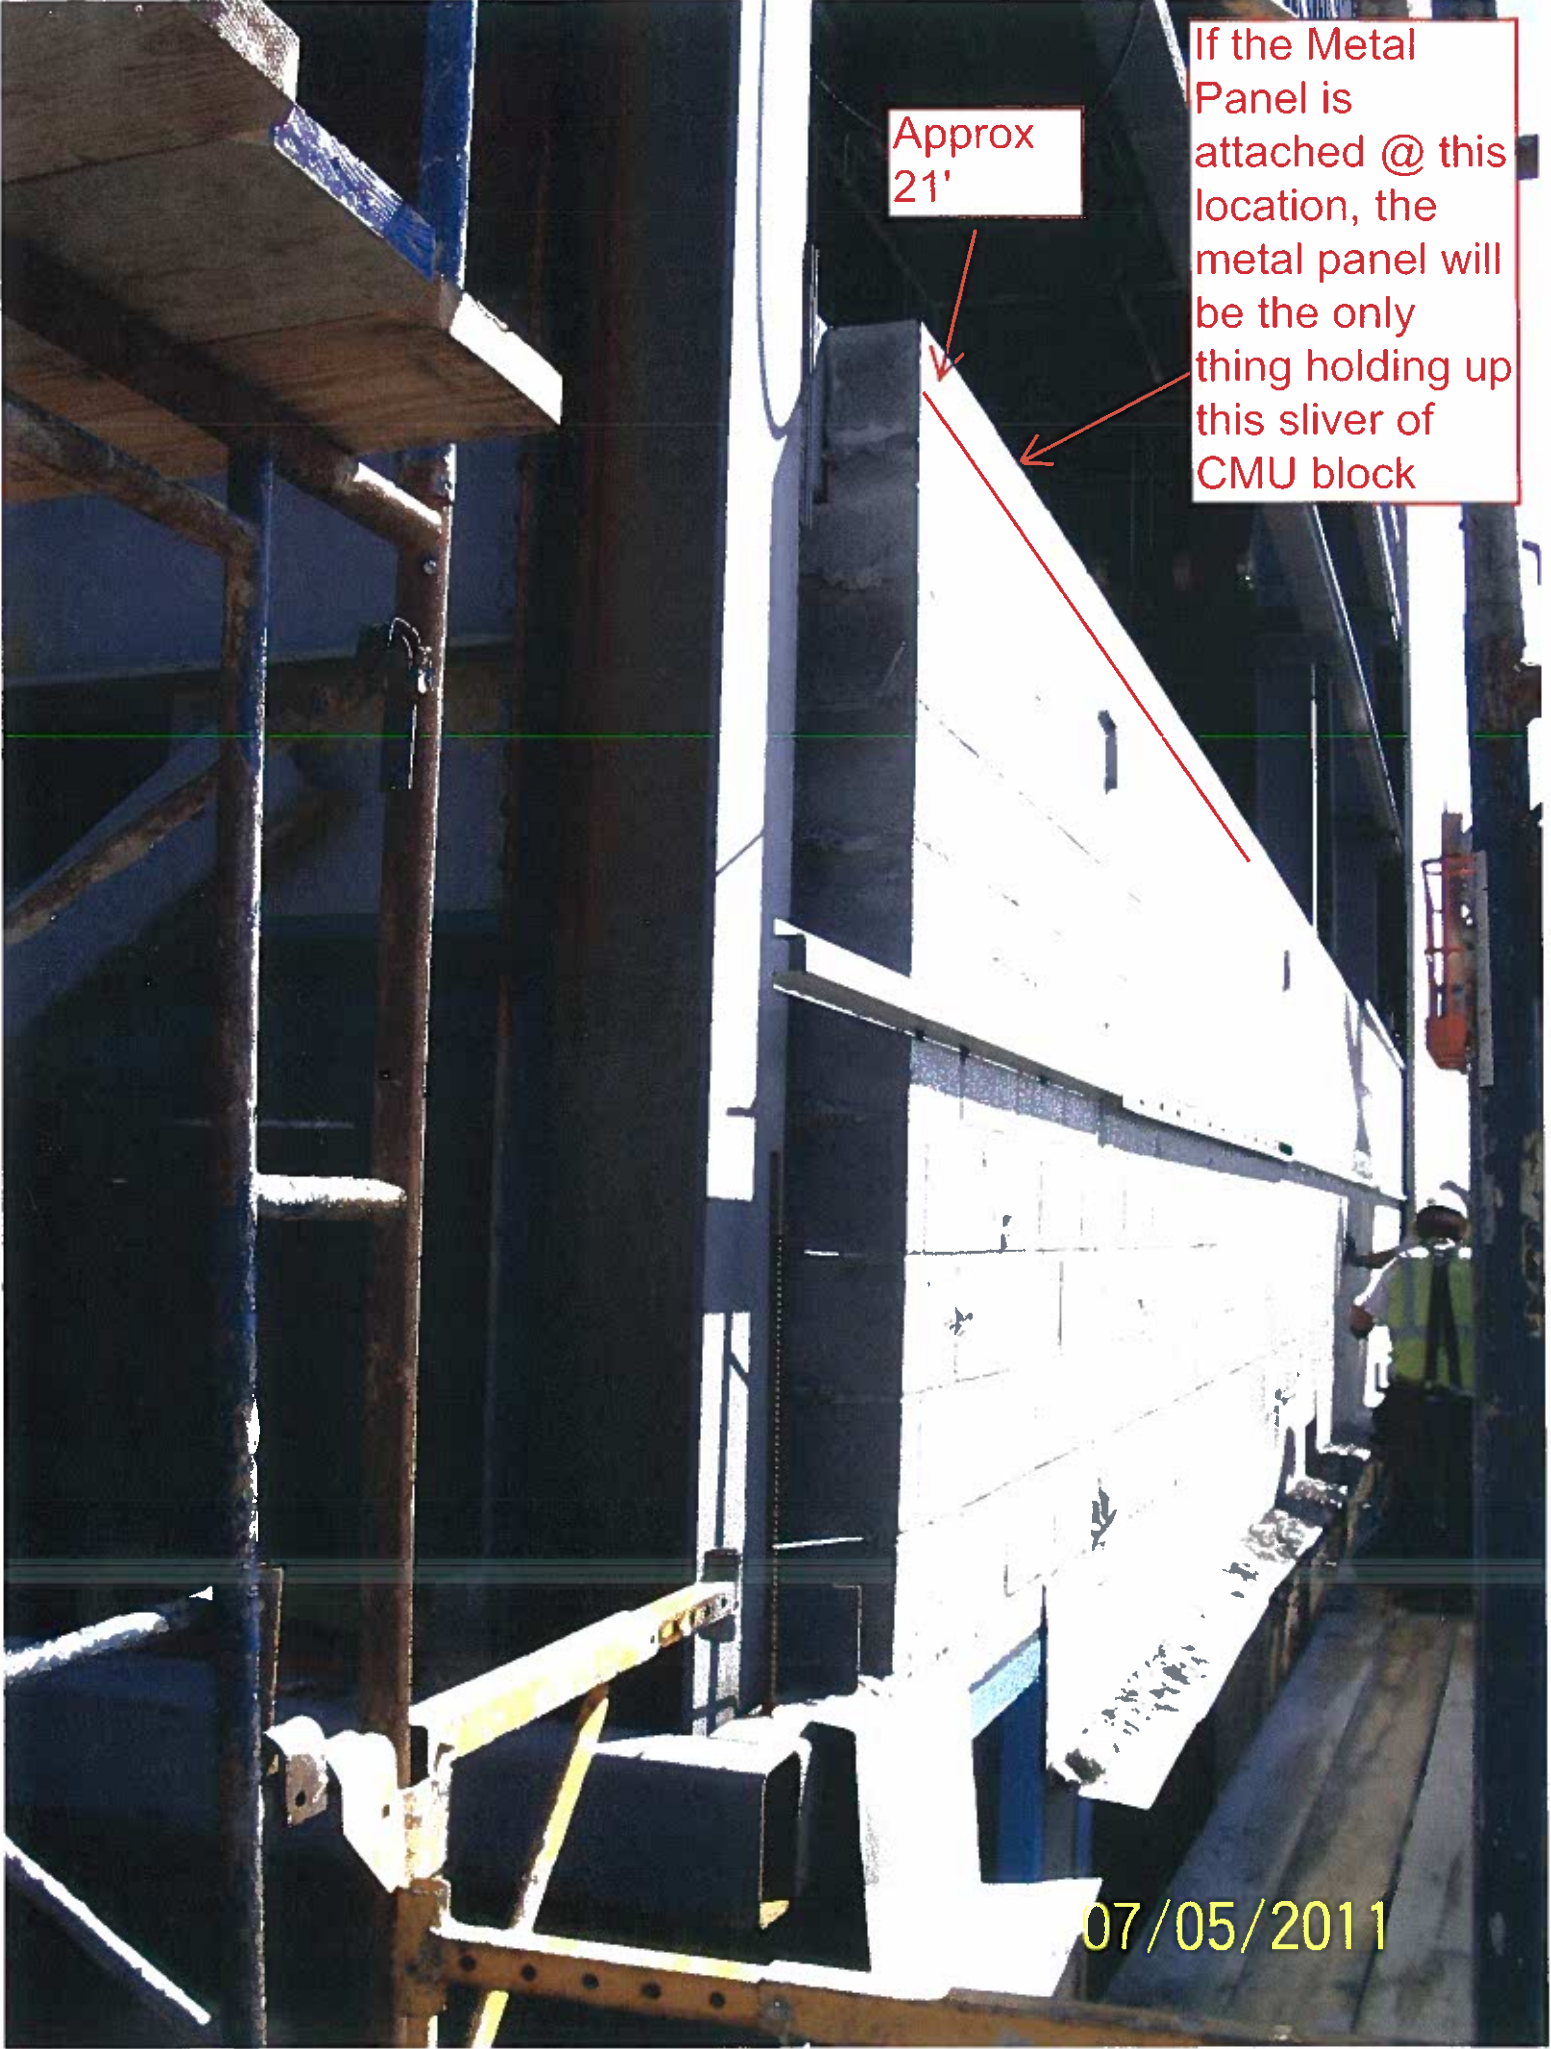

Approx
21'

If the Metal
Panel is
attached @ this
location, the
metal panel will
be the only
thing holding up
this sliver of
CMU block

07/05/2011

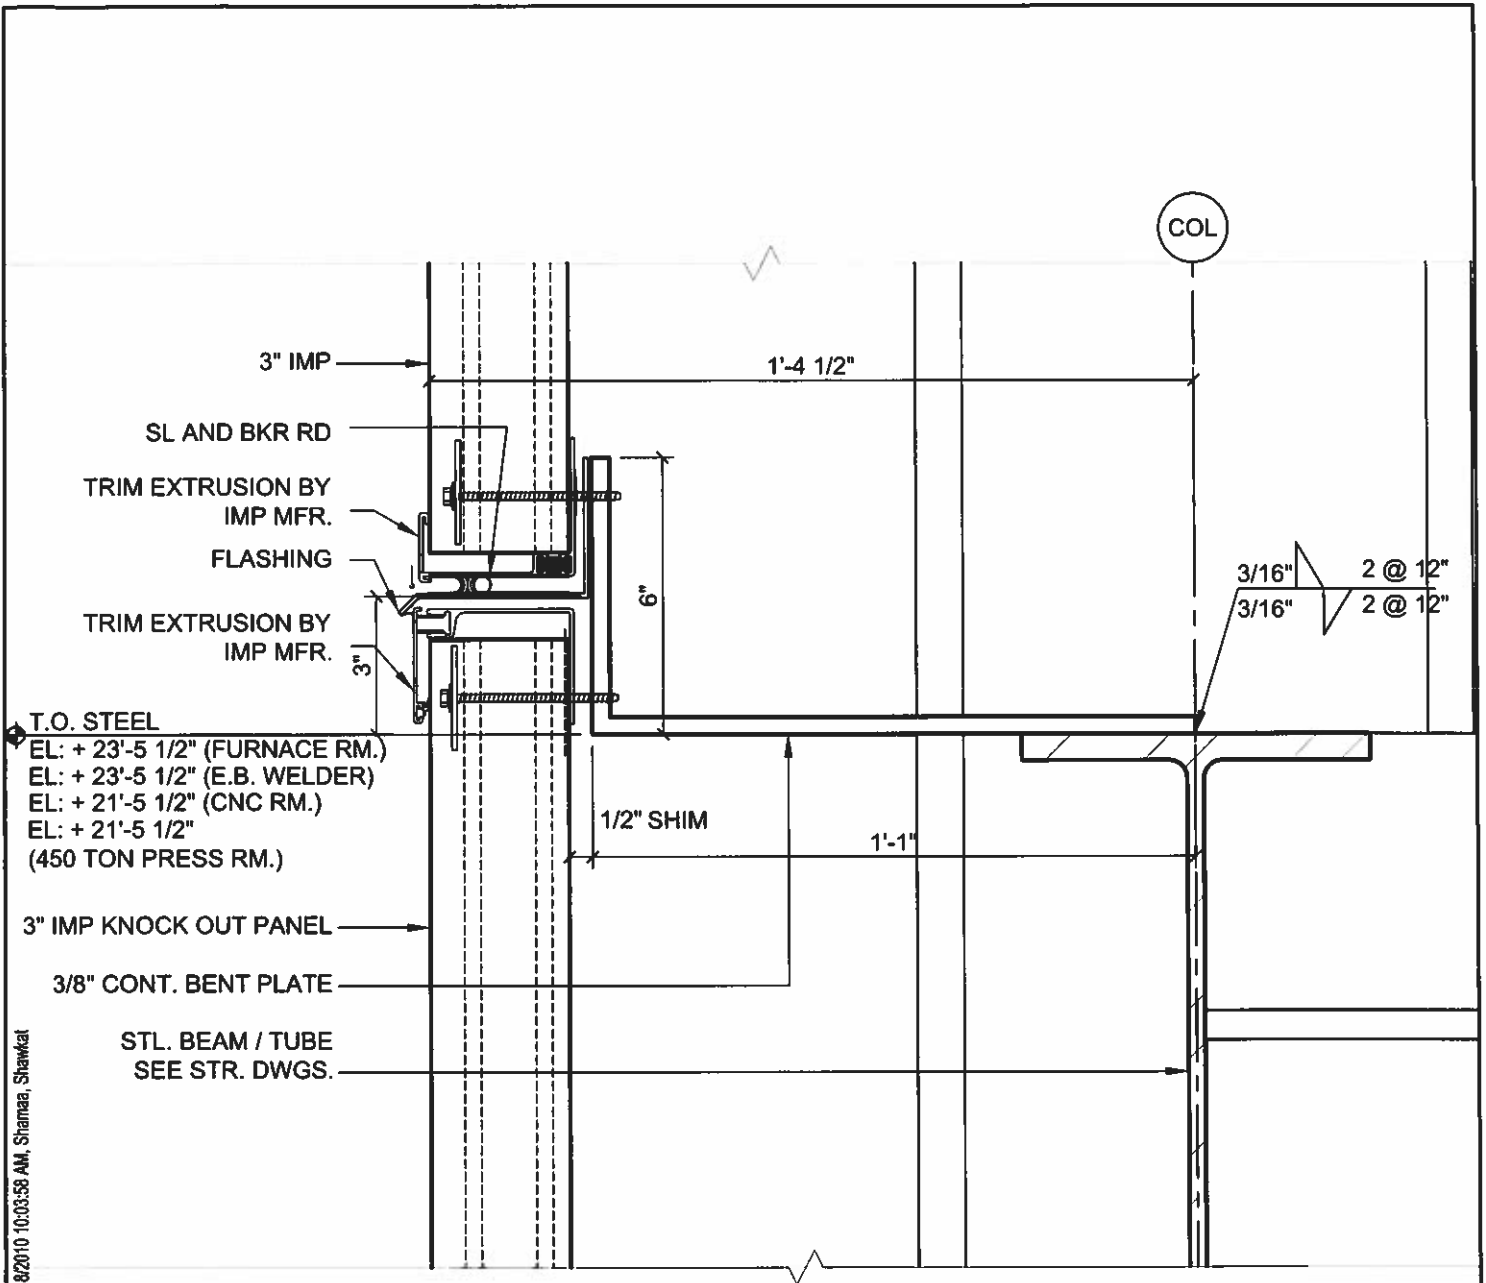

4 SECTION DETAIL AT HEAD OF EXTERIOR KNOCK OUT PANELS
3" = 1'-0"

W:\20080400\ARCH\SHSHEET FILES\TLR_A3146.dwg, 10/18/2010 10:03:58 AM, Shamaa, Shankat

	PROJECT	JEFFERSON LAB TEDF TWO	PROJECT NO.	20080400	DWG. DATE	07/05/2010
	DRAWING TITLE	SECTION DETAIL AT HEAD OF EXTERIOR KNOCK OUT PANELS	REF. DWG.	---	REV. DATE	---
			SCALE	3" = 1'-0"	DRAWING NO.	CPA-0029
			DWN. BY	S.S.		