


ZONE	REV	DESCRIPTION	REVISION HISTORY	DATE	APPROVED
ALL	A	REVISED AS INSTALLED	REV 09/2008	11/7/06	DAE


FOR CONTINUATION
SEE DRAWING NO.
28405-E-0034 REV N

FOR CONTINUATION
SEE DRAWING NO.
28405-E-0037 REV K

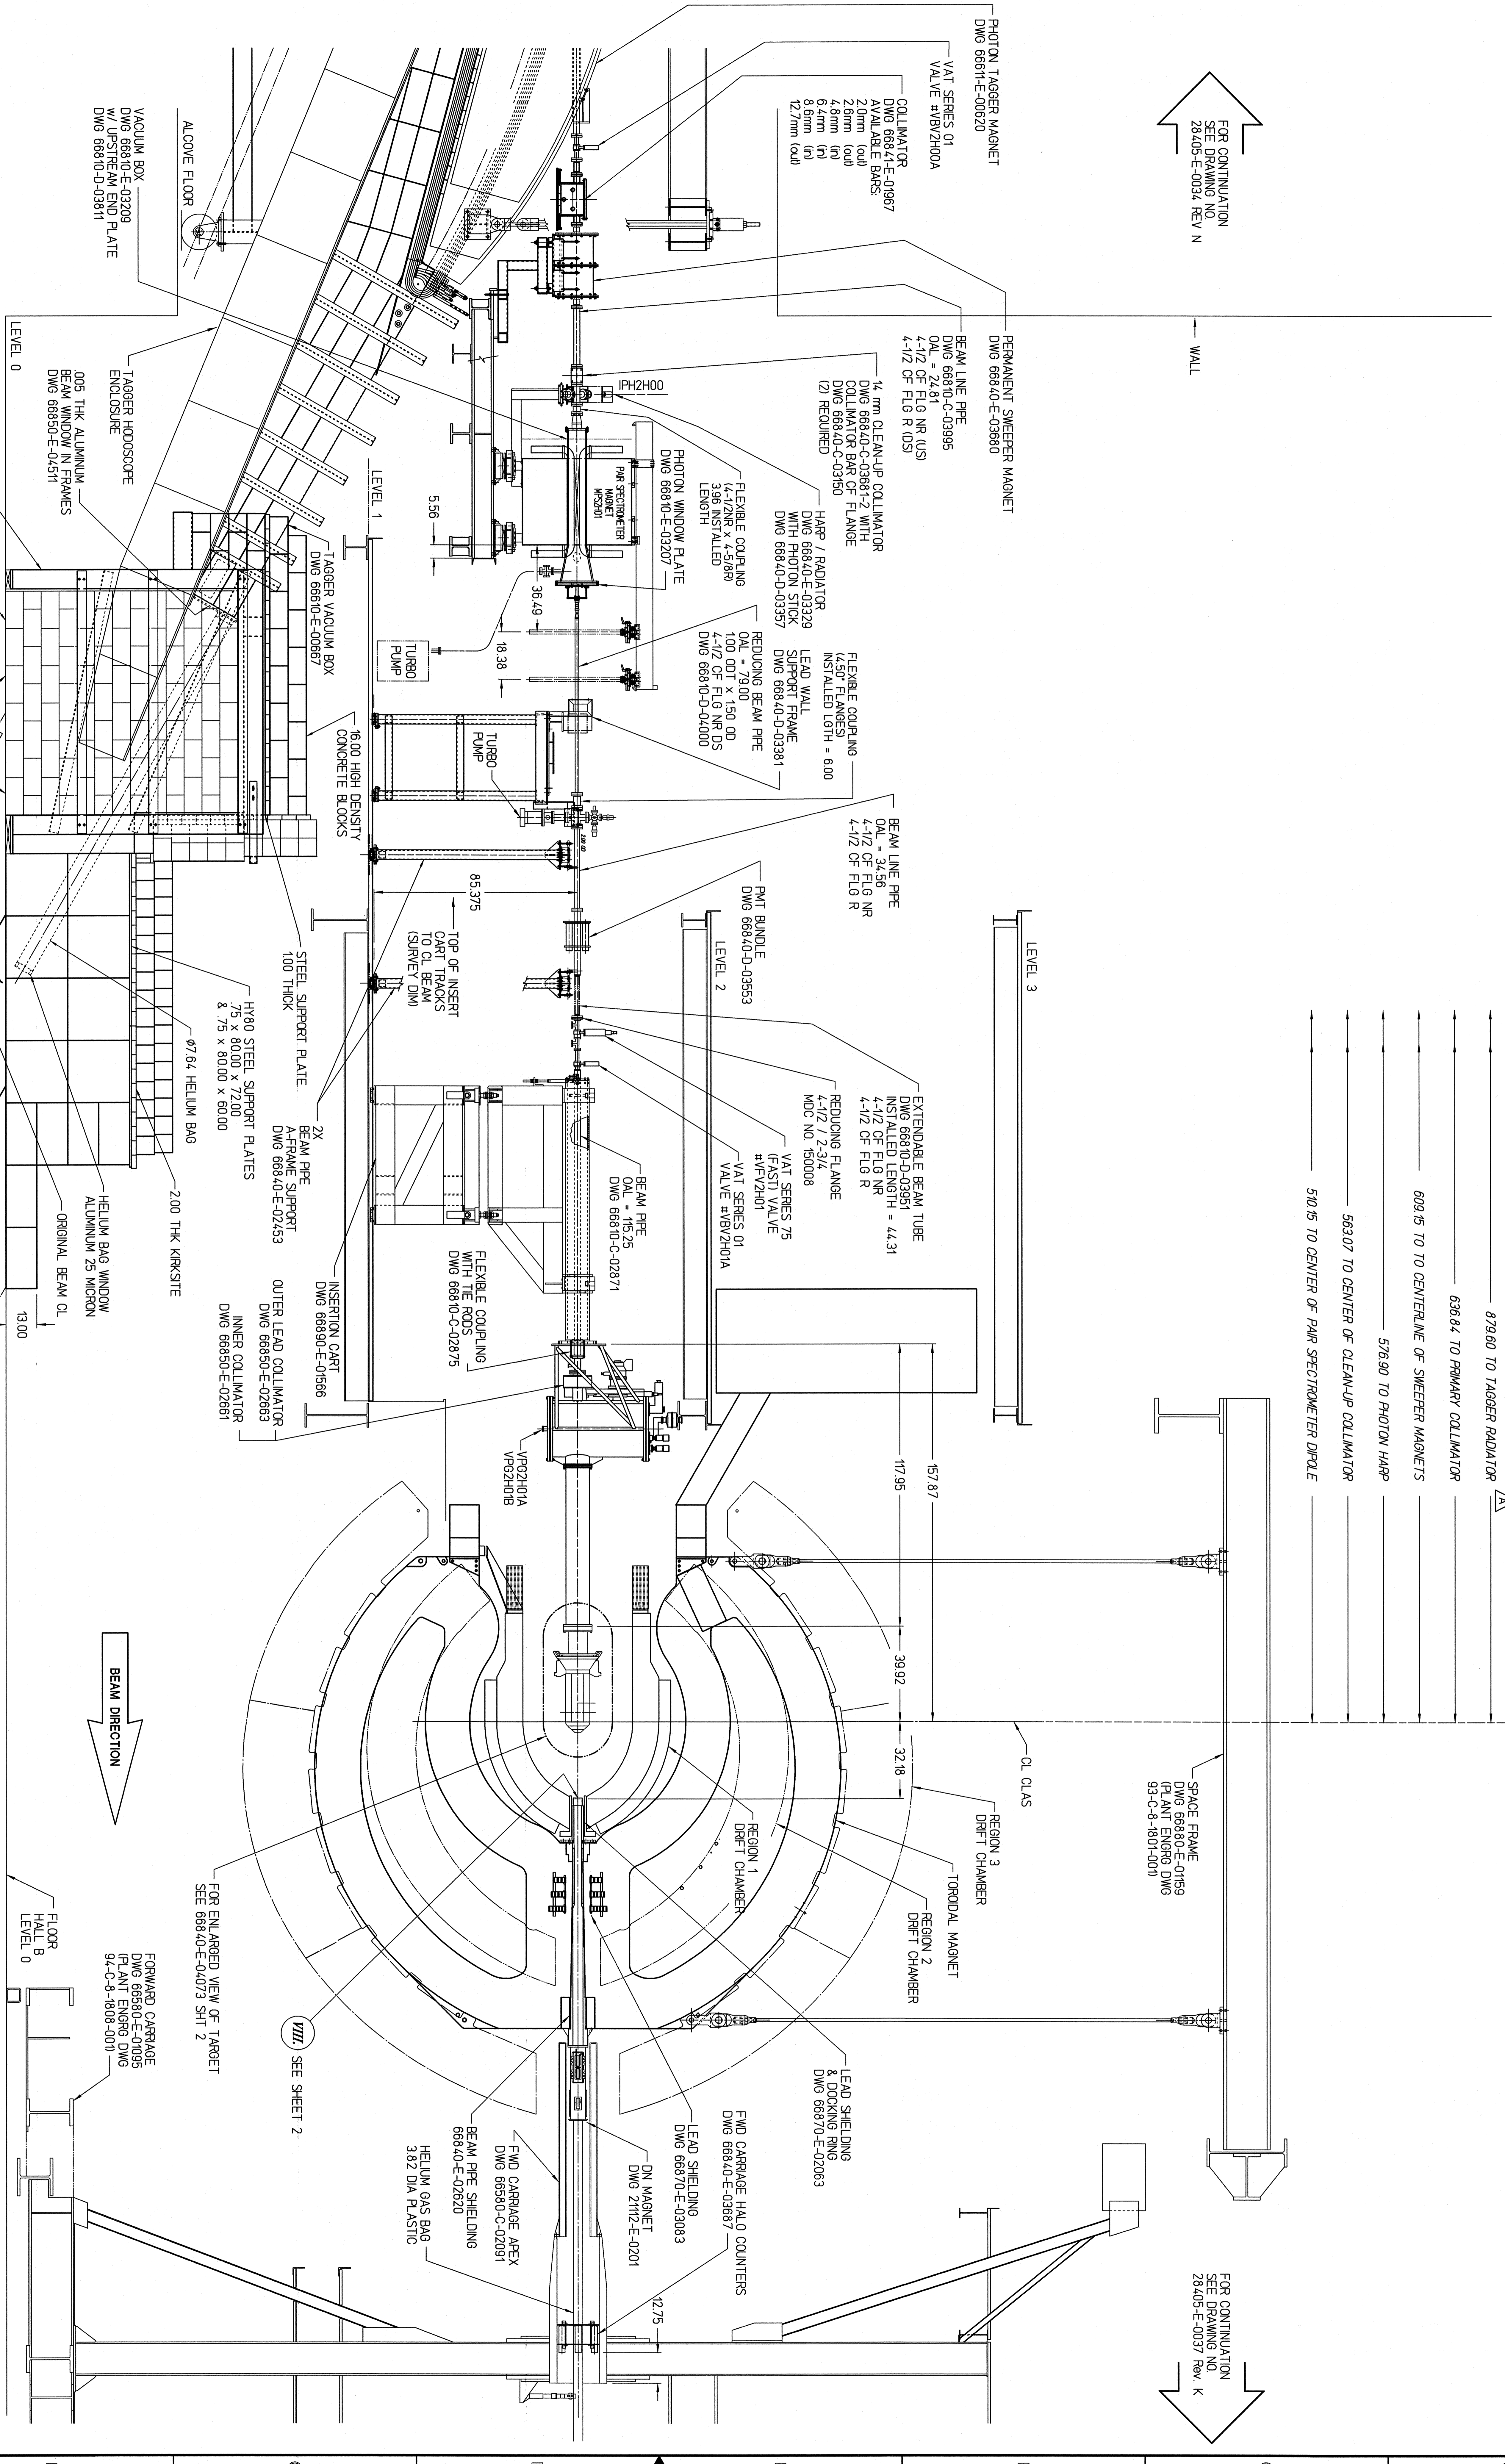

PROJECT CONTROL SHEET

DATE: 11/7/06

SCALE: 1/24

PROJECT: HALL B BEAM LINE ASSEMBLY FROM TAGGER MAGNET THRU FWD CARRIAGE FOR DT30 RUN (FALL 2006)

66840-E-04661

SHEET 1 OF 3

APPROVED: [Signature]

DATE: 11/7/06

BY: [Signature]

SCALE: 1/24

PROJECT: HALL B BEAM LINE ASSEMBLY FROM TAGGER MAGNET THRU FWD CARRIAGE FOR DT30 RUN (FALL 2006)

66840-E-04661

SHEET 1 OF 3